

**2b. Drops 14-15 Hydro Site  
Background Information**

IRRICAN Power



January, 2011

## **Table of Contents**

3.1 Geographic Location and Site Plan

3.2 General Site Parameters

3.3 Conceptual Design from Chin-Stafford Hydro Feasibility Study (UMA, 2000)

3.4 Interconnection

3.5 Scan of Drawings main canal cross section drawings, drop structures

3.6 Potential Hydroelectric Project Investigations within the St. Mary River Project (UMA, 2001)

**[Hard copy available upon request]**

3.7 Relevant Historical Data [**CD available upon request**]

Daily Flows, 1994-2009

Daily reservoir elevation data, 1994-2009

Scan of main canal cross sections and drop structures 14, 15 and 17

### **3.1. General Location and Site Plan**

The site is located approximately 25 km east of the City of Lethbridge on the St. Mary Main canal as shown on Figure 3.1 of the following page. The main canal system is owned and operated by the St. Mary River Irrigation District (SMRID), in conjunction with the Taber and Raymond Irrigation Districts.

The main canal system is approximately 308 km in length and starts south of the town of Raymond. The canal continues north-east past the City of Lethbridge (at approximately kilometre 40) and terminates near Medicine Hat. The system operates during the irrigation season, generally from late-April to early-October. The proposed hydro site incorporates the head from two in-line drops on the main canal.

The flowrate at Drops 14-15 is dictated by irrigation demand and fluctuates accordingly. The main canal flow at this location (design flow = 36.9 m<sup>3</sup>/s) combined with an average gross head of 15.0 m, provides Irrican Power or other potential developers with an opportunity for hydro power generation.

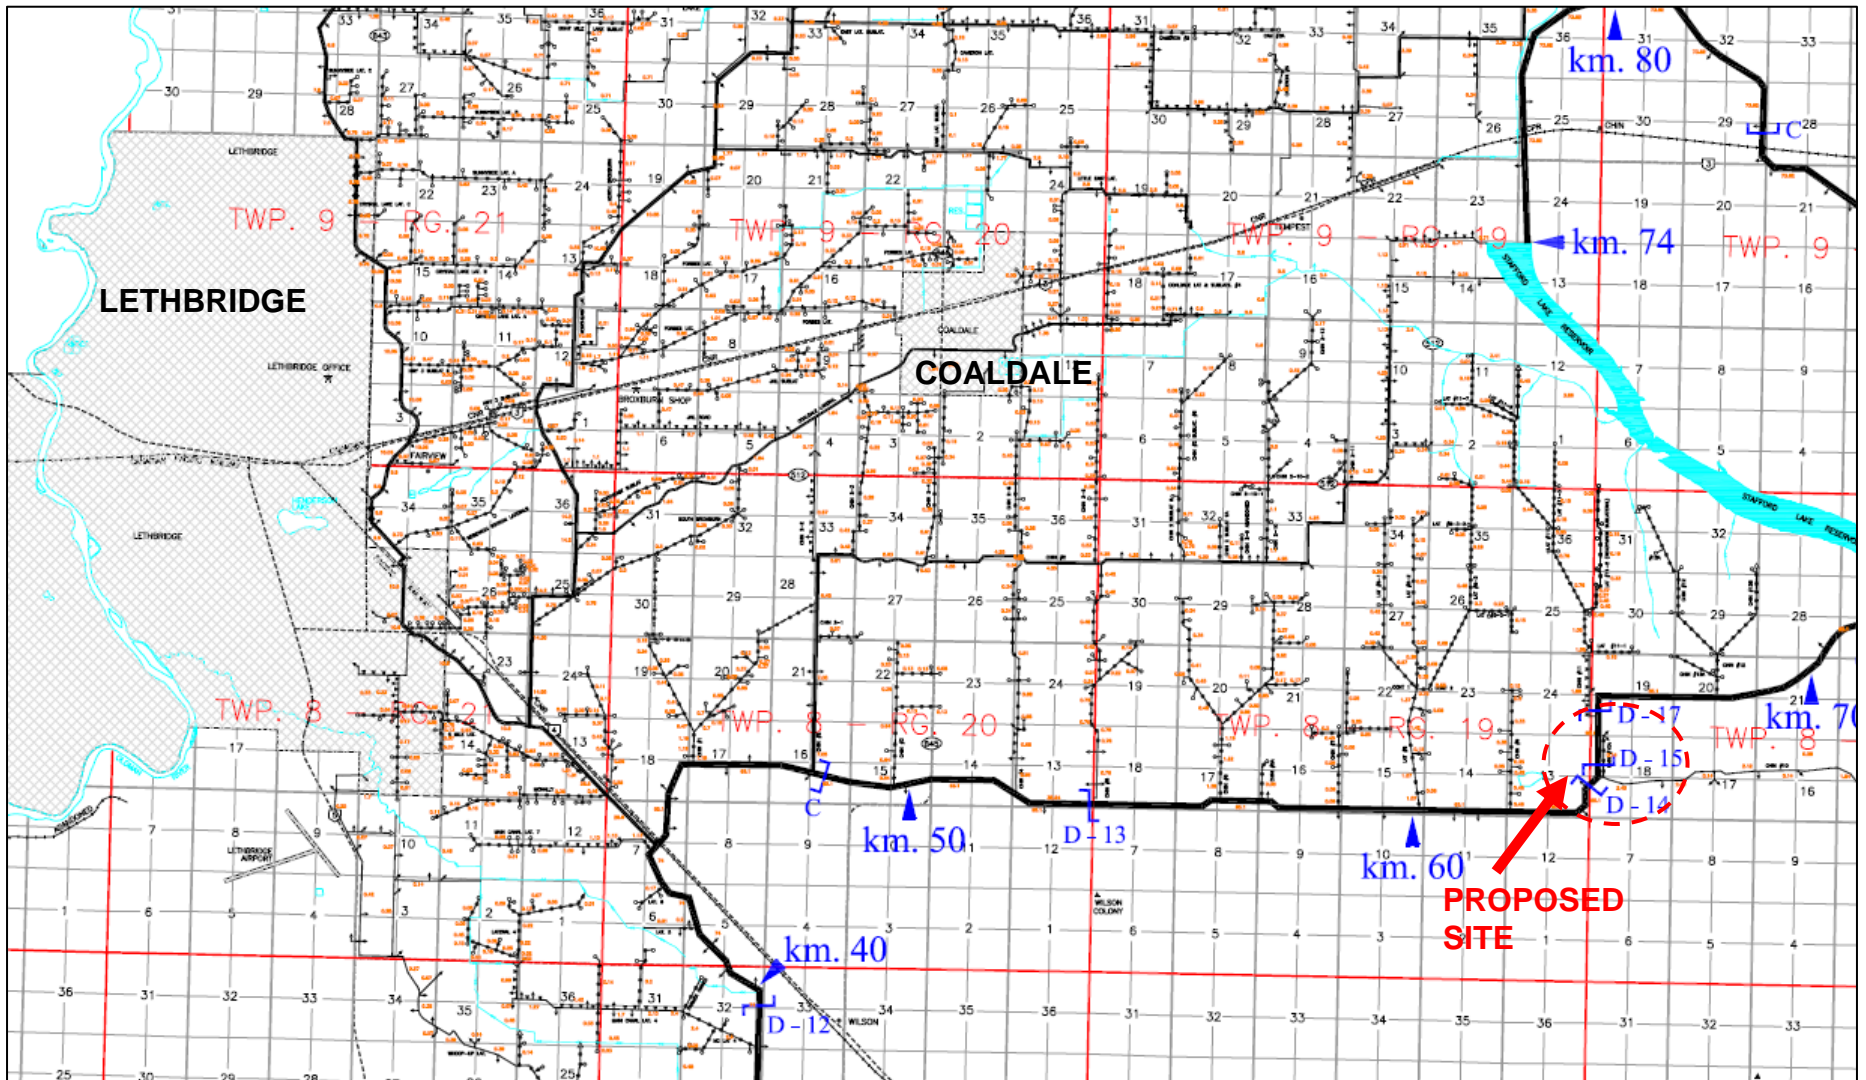


Figure 3.2 Site Location Plan, Drops 14-15 Hydro Site

### **3.2. General Site Parameters**

- a) UMA Design Flow = 36.9 m<sup>3</sup>/s
- b) UMA Design head = 14.95 m

Above from *Potential Hydroelectric Project Investigations within the St. Mary River Project (UMA, 2001)*

- c) Maximum flowrate = 55 m<sup>3</sup>/s.

Flowrates will vary according to irrigation demand; see table 3.1 below.

**Table 3.1. Chin-Stafford flow data, 2000-2010**

<b>Year</b>	<b>Start-up Date</b>	<b>End Date</b>	<b>Q average (m<sup>3</sup>/s)</b>
2000	28-Apr-00	16-Oct-00	29
2001	03-May-01	10-Oct-01	21
2002	07-May-02	21-Oct-02	34
2003	30-Apr-03	17-Oct-03	23
2004	30-Apr-04	29-Oct-04	24
2005	02-May-05	20-Oct-05	22
2006	30-Apr-06	31-Oct-06	21
2007	08-May-07	28-Oct-07	25
2008	30-Apr-08	20-Oct-08	26
2009	25-Apr-09	18-Oct-09	24
2010	01-May-10	08-Oct-10	17

### **Potential for hydro development**

It is envisioned that a 5 to 7 MW run-of the river hydro plant could be constructed at the site, producing between 15,000 to 18,000 MW-hrs per year.

### **3.3 Conceptual Design from UMA, 2001**

See following page. UMA's layout incorporated the head from Drops 14 (sta 64+040) and Drops 15 (station 64+451). There is another downstream drop structure at station 65+720 that could possibly be incorporated to increase the head by an additional 5.4 metres, (requiring a longer/deeper tailrace canal).

### **3.4 Interconnection**

The power plant would be connected to the existing 25 KV line located in the vicinity of this project (*more information to be provided*). Other requirements consist of the transformer substation, approximately 0.5 km (verify) of power line and an electrical breaker.


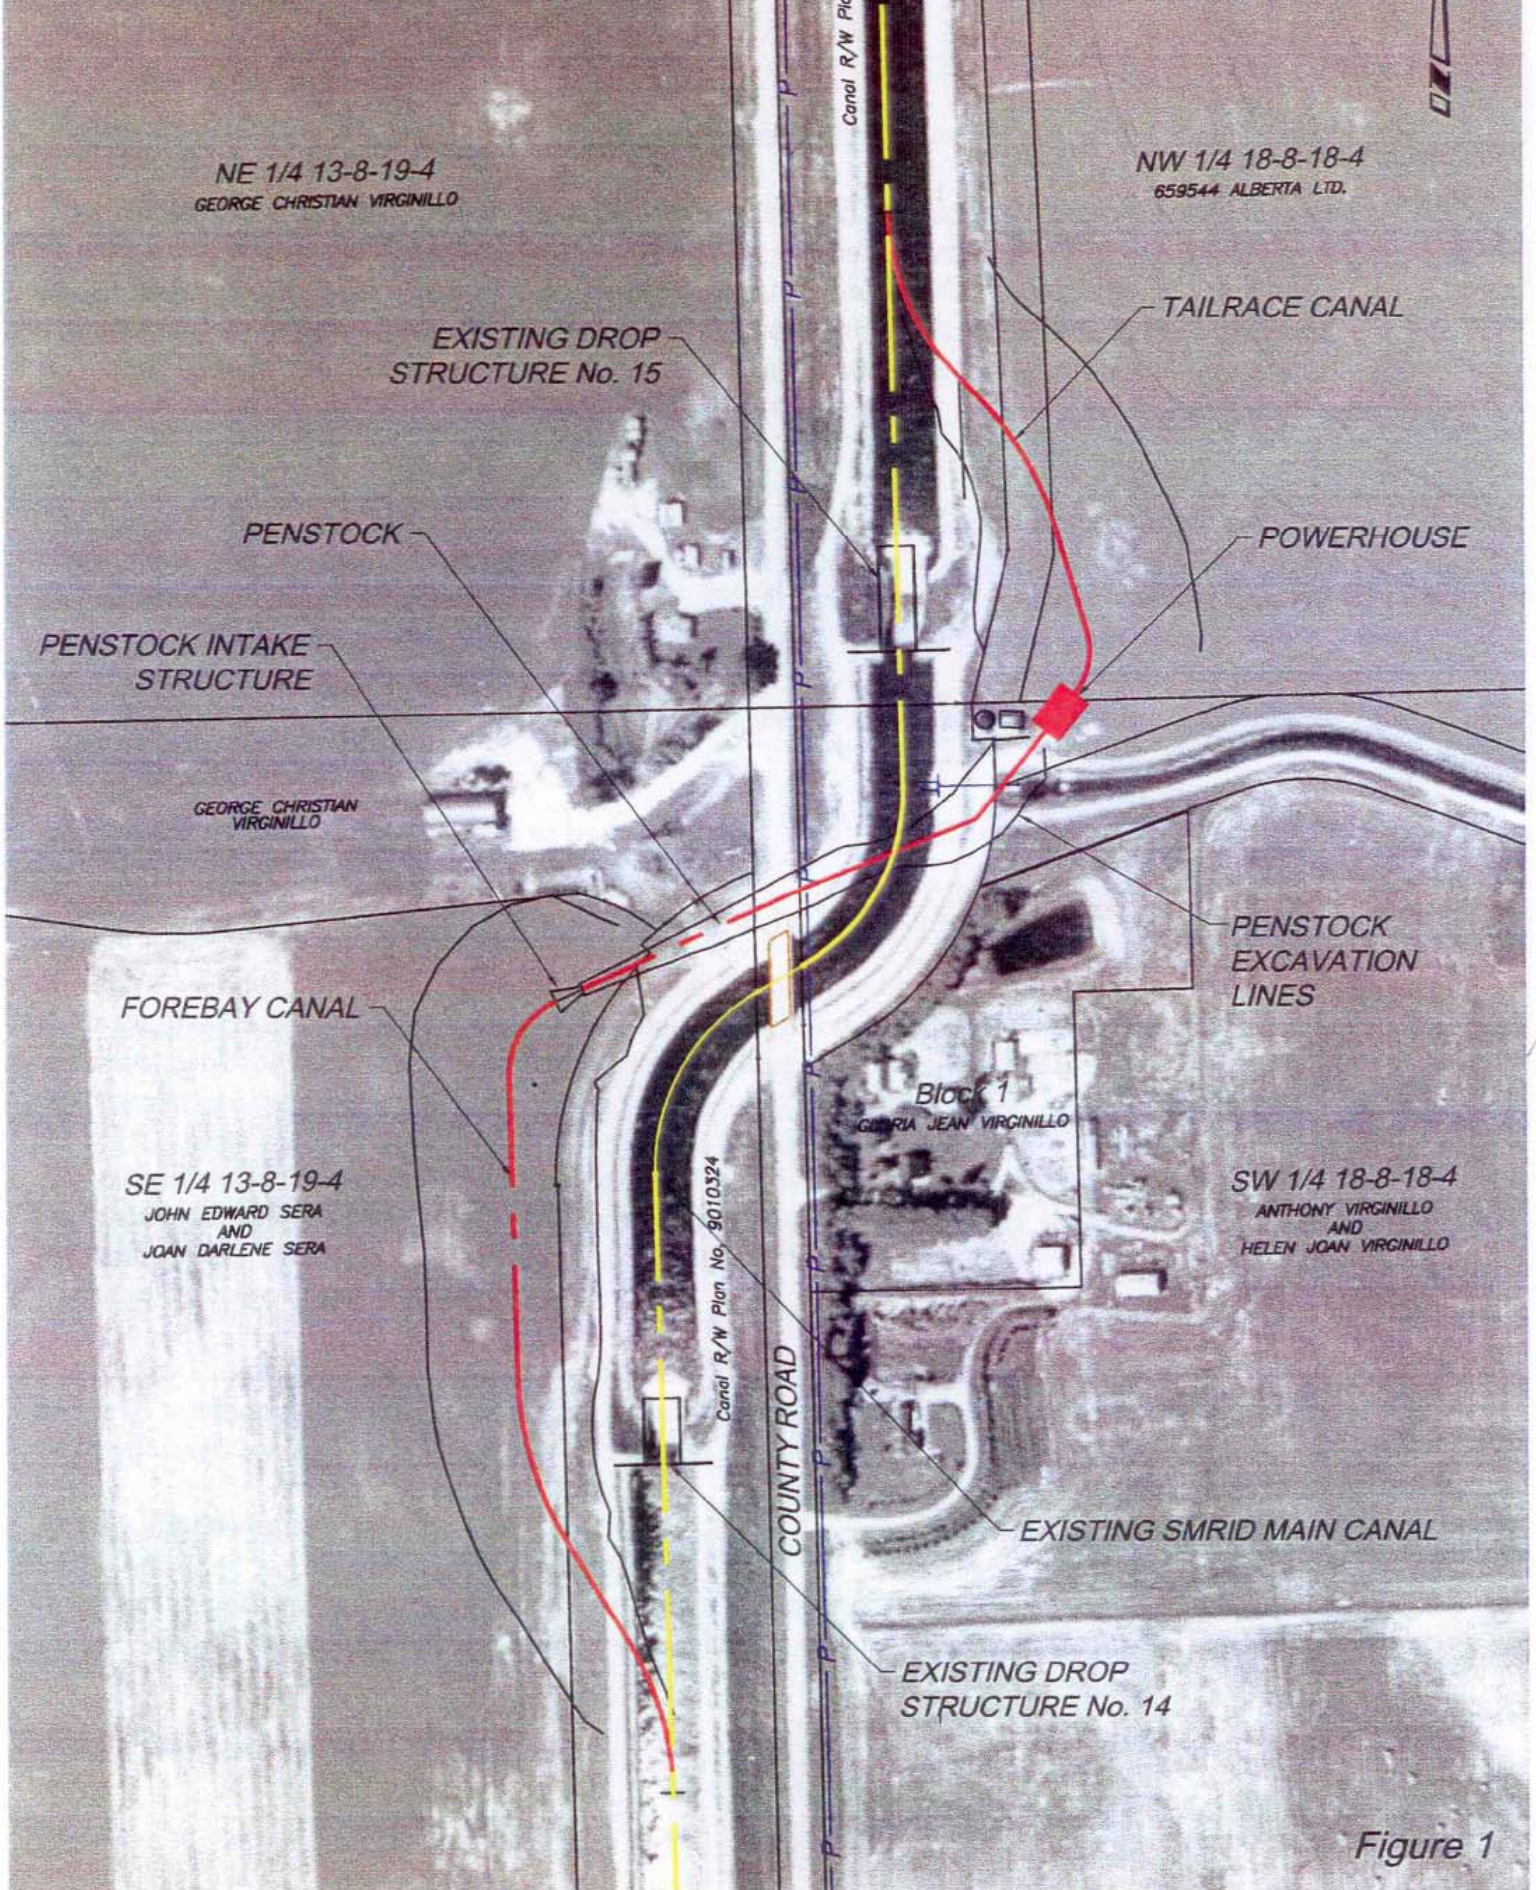


Figure 1

Conceptual Design (from 'Potential Hydroelectric Project Investigations within the St. Mary River Project', UMA, 2001)

### 3.5 Scan of Drawings main canal cross section drawings, drop structures

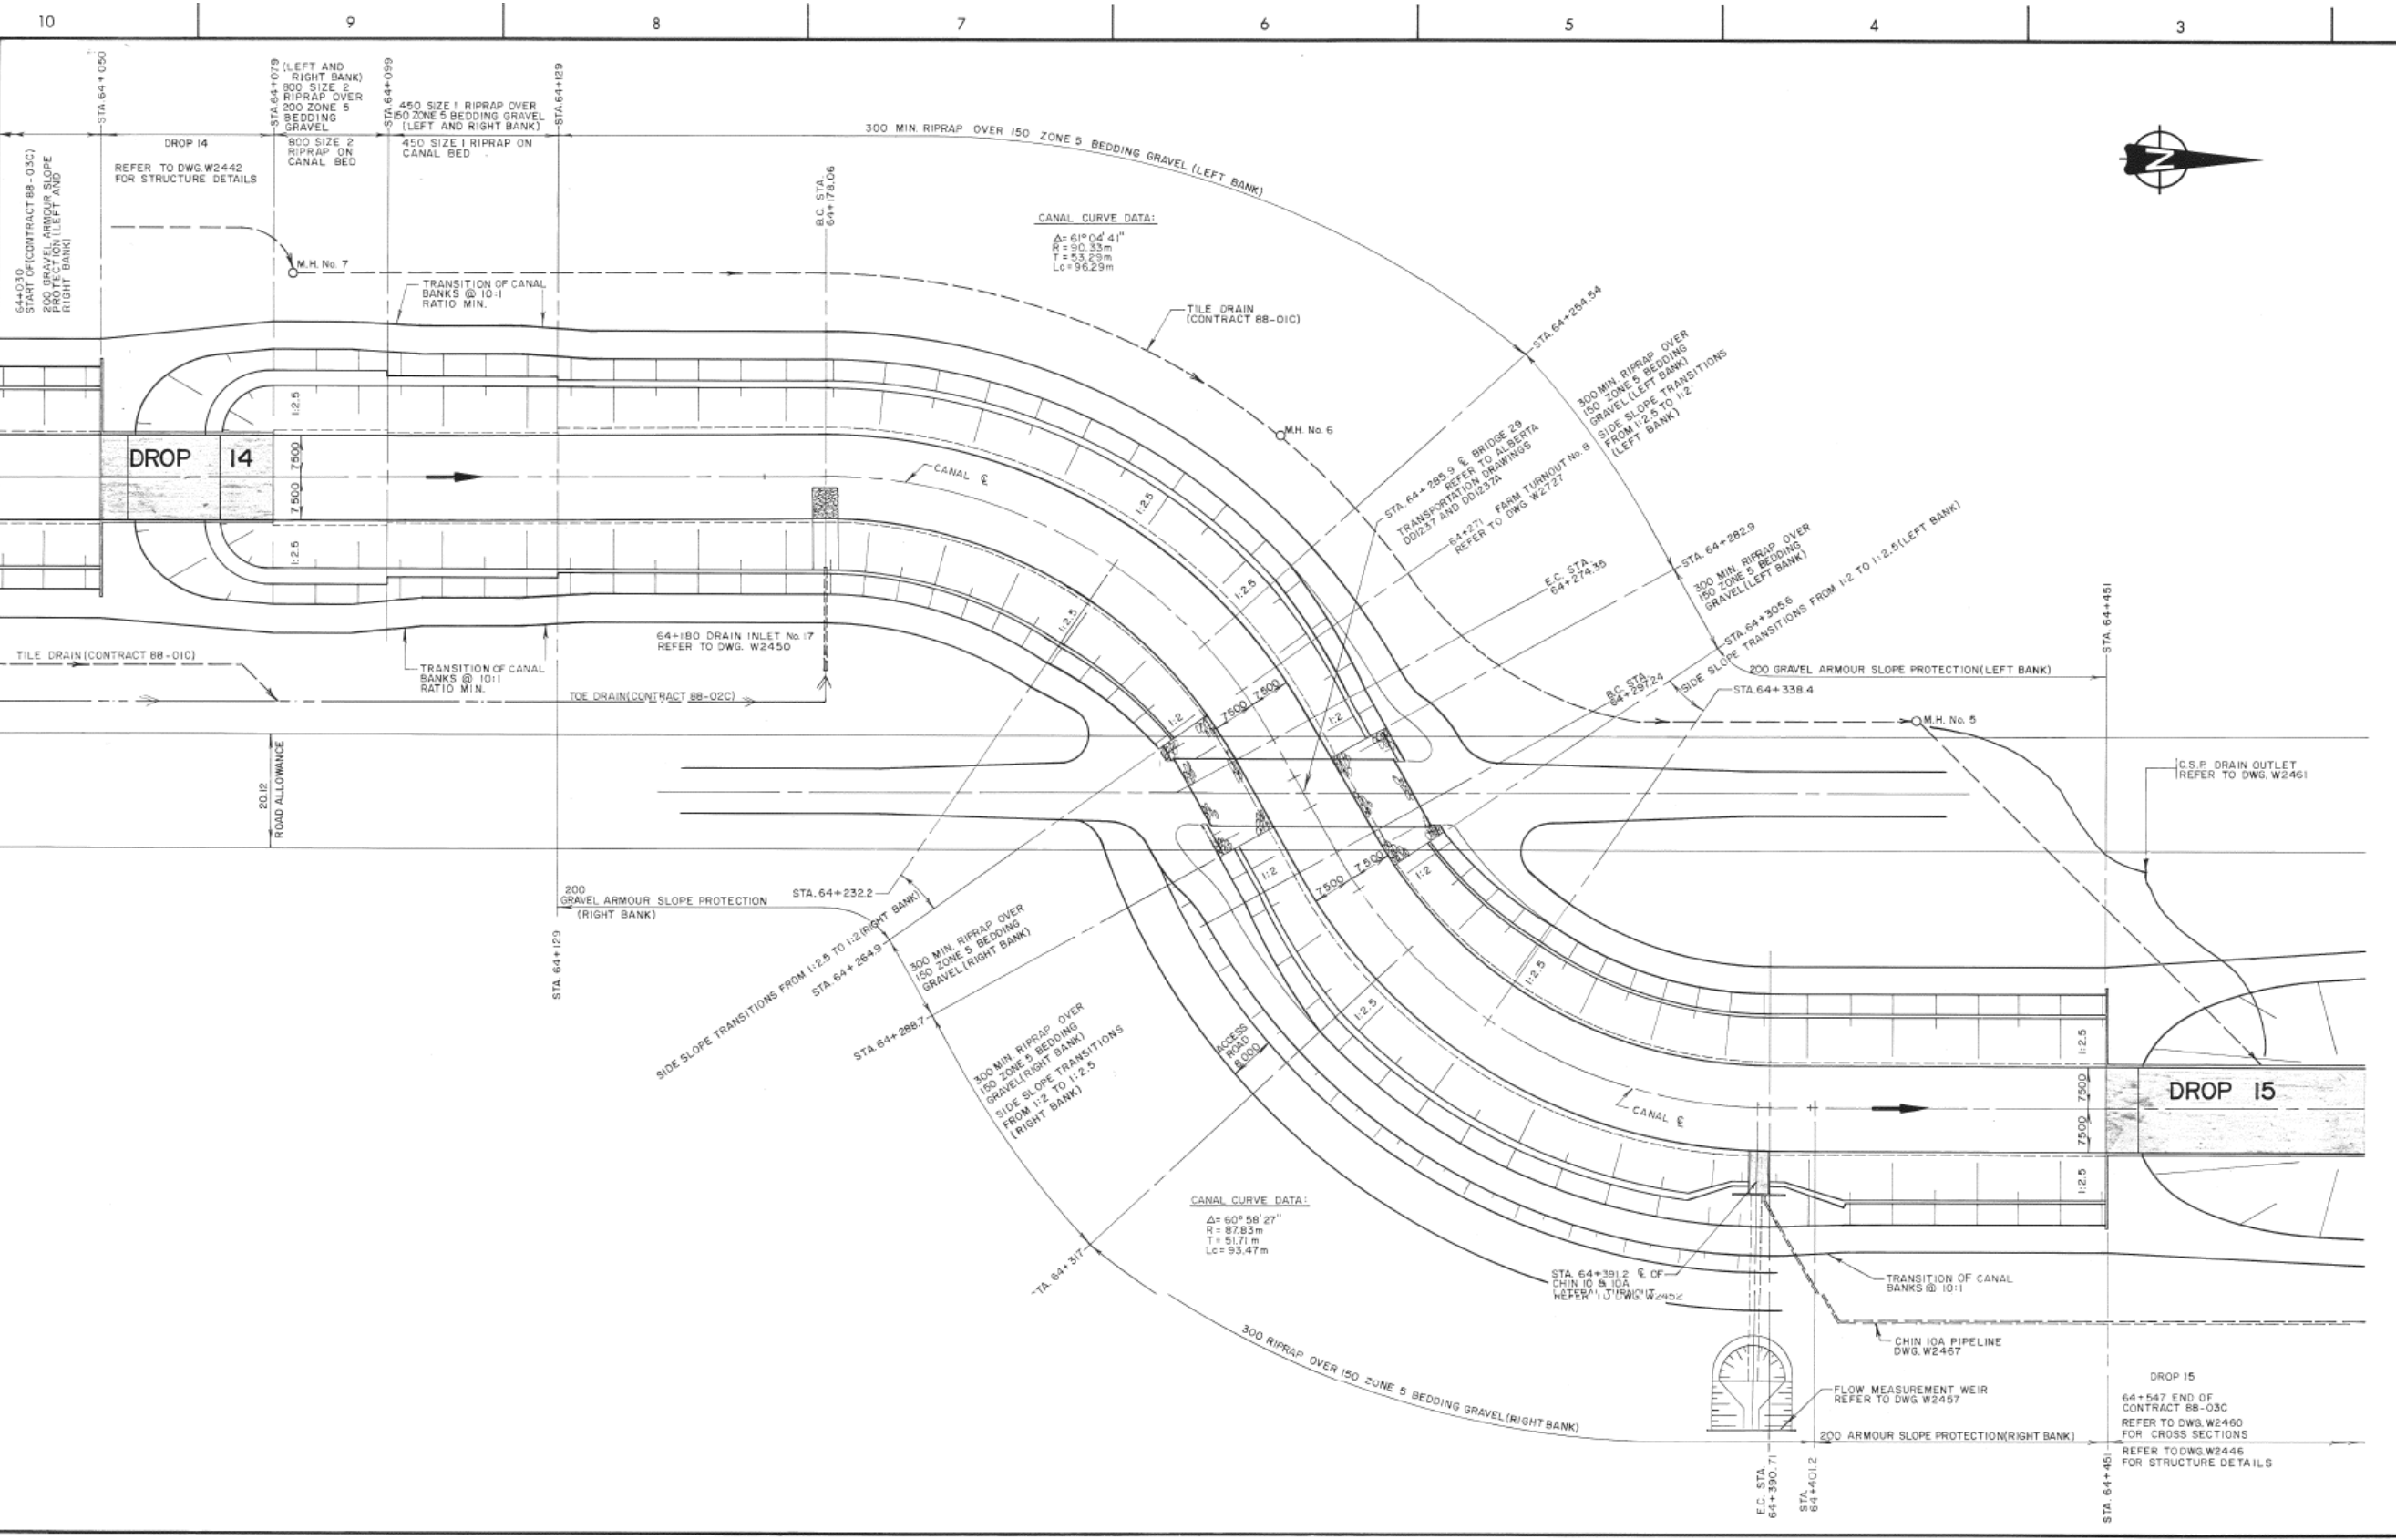

ST. MARY RIVER IRRIGATION DISTRICT  
 ALBERTA ENVIRONMENT

Heritage Fund

**RECORD DRAWING**  
 18-09-91 SIGNED [Signature] PROJECT SUPERVISOR

DO NOT SCALE THIS DRAWING


REV	D	M	Y	ISSUE / REVISION DESCRIPTION	DRN	SUPV	DES	CHK	ENG
2	15	03	90	ISSUED FOR RECORD DRAWING					
1	06	09	88	ISSUED FOR CONSTRUCTION					
0	20	06	88	ISSUED FOR TENDER					

ENGINEER  
 PERMIT TO PRACTICE  
 UMA ENGINEERING LTD  
 Signature: [Signature]  
 Date: 26/07/88  
 PERMIT NUMBER: P 329  
 The Association of Professional Engineers, Geologists and Geophysicists of Alberta


**UMA** UMA Engineering Ltd.  
 Engineers & Planners

ST. MARY RIVER IRRIGATION DISTRICT  
 MAIN CANAL REHABILITATION  
 RIDGE RESERVOIR TO CHIN RESERVOIR REACH  
 km. 64 TO km. 65  
 DROP 14 TO DROP 15 SHT. 2 of 31  
 CANAL AND BANK TRANSITION PLAN VIEWS


PROJECT No. 1758-060-00 LETHBRIDGE, ALBERTA	CODE CONTRACT 88-03C	DRAWING No. <b>R W2441</b>	ISS/REV <b>2</b>
---	----------------------------	-------------------------------	---------------------

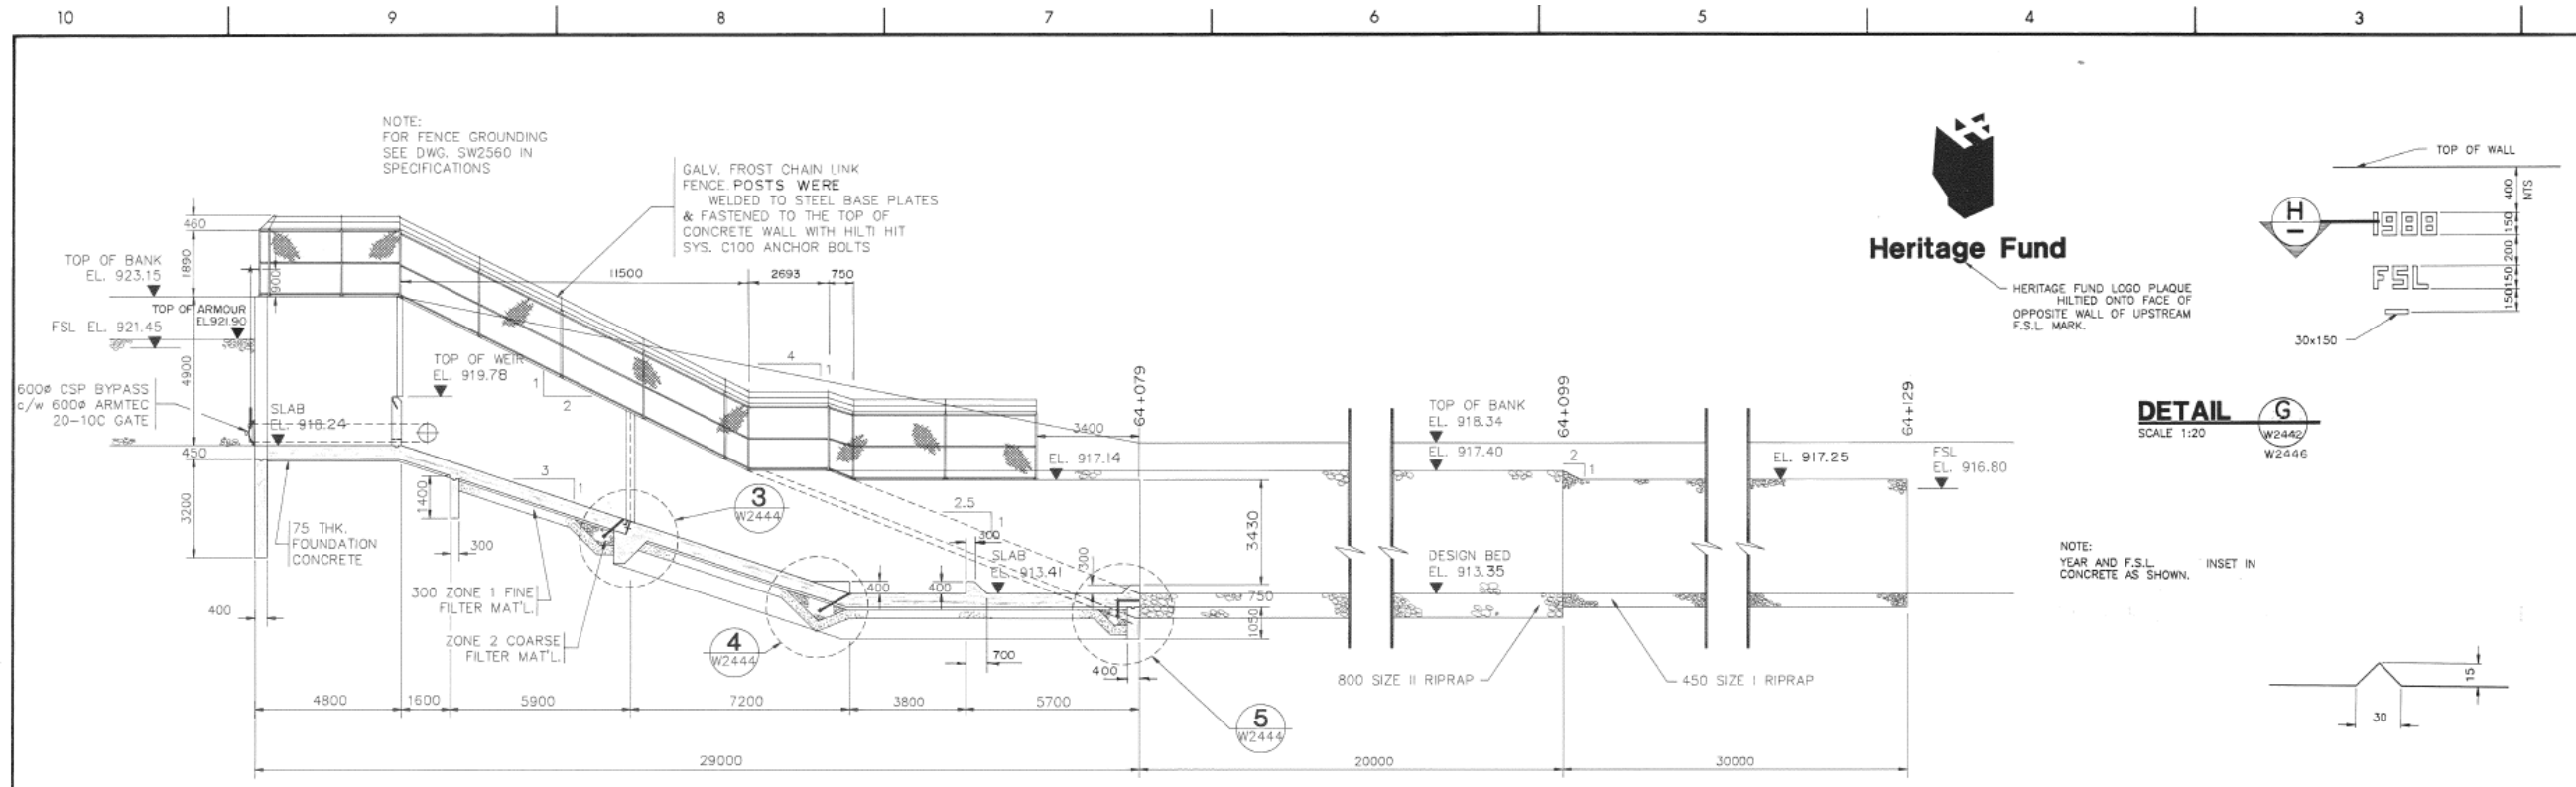


**SECTION A**  
SCALE 1:100 W2442

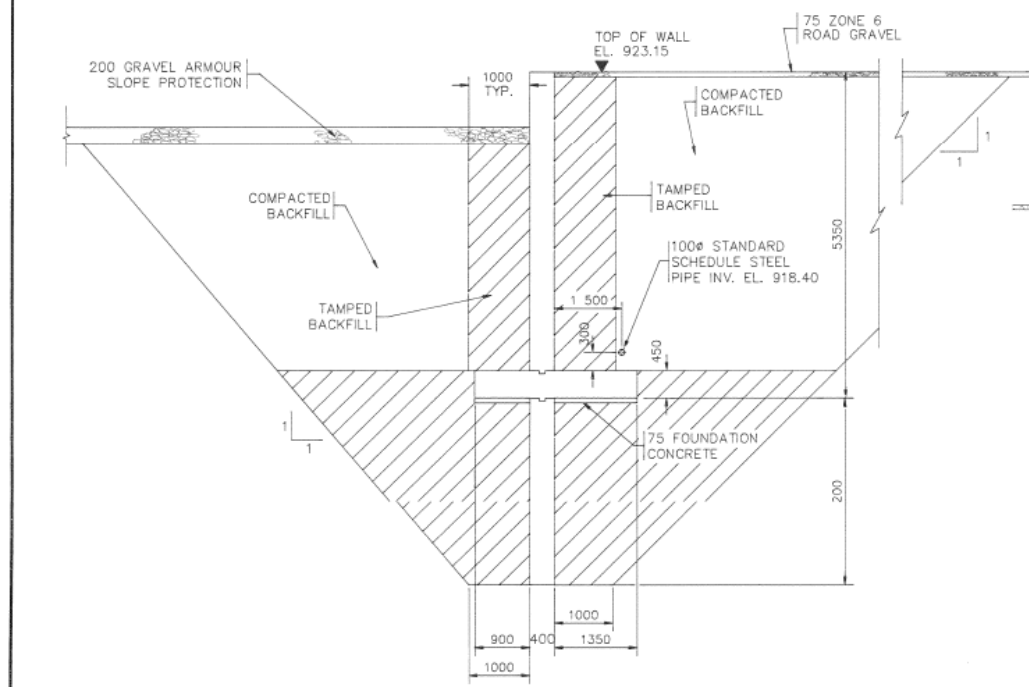

**SECTION B**  
SCALE 1:50 W2442

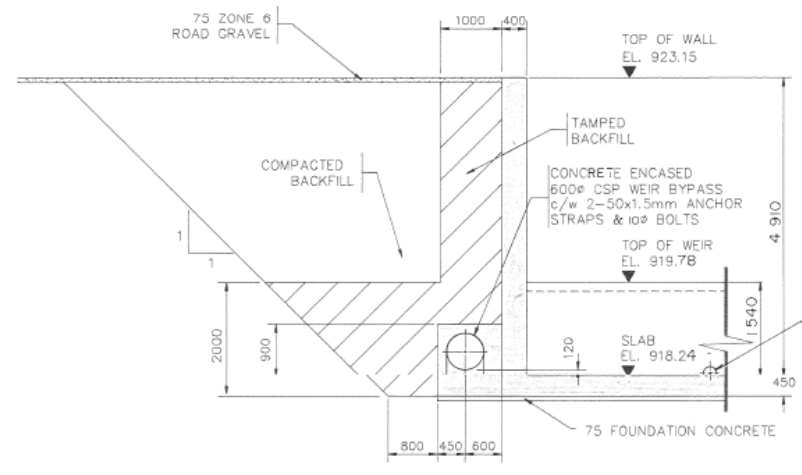


**SECTION C**  
SCALE 1:50 W2442

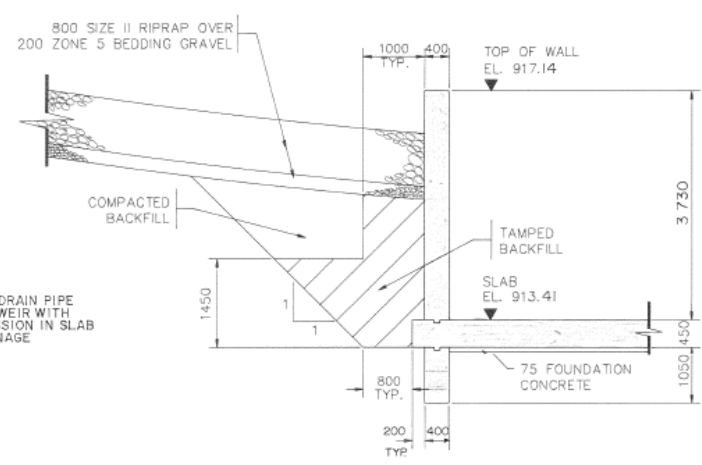

**SECTION D**  
SCALE 1:50 W2442



HERITAGE FUND LOGO PLAQUE  
MOUNTED ONTO FACE OF  
OPPOSITE WALL OF UPSTREAM  
F.S.L. MARK.

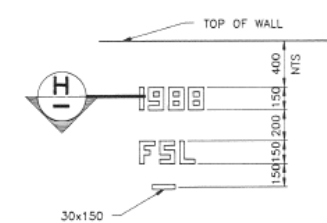

**DETAIL G**  
SCALE 1:20 W2442

NOTE:  
YEAR AND F.S.L.  
CONCRETE AS SHOWN.

**GENERAL NOTES**

1. ALL MISCELLANEOUS STEEL SHALL BE TO CSA 300.21 M. GRADE 300 W UNLESS OTHERWISE NOTED.
2. HOLLOW STRUCTURAL SECTIONS SHALL HAVE A MINIMUM YIELD STRENGTH OF 350 MPa.
3. ALL MISCELLANEOUS STEEL SHALL BE HOT DIPPED GALVANIZED UNLESS OTHERWISE NOTED.
4. HOT DIP GALVANIZING SHALL BE IN ACCORDANCE WITH CSA G184-M 1981.
5. CONTRACTOR SHALL PROVIDE ALL ANCHOR BOLTS IN STRICT ACCORDANCE WITH THE RELEVANT EQUIPMENT SUPPLIER'S CERTIFIED DRAWINGS.
6. ALL WELDING SHALL BE PERFORMED IN ACCORDANCE WITH CSA W59 - 1984, AND ALSO UNDER CSA W47.1 AND CSA W48 SERIES.
7. FABRICATION TOLERANCES AND BOLTED CONNECTIONS SHALL BE IN ACCORDANCE WITH CSA S16 SERIES.
8. ALL CONCRETE SHALL HAVE A MINIMUM COMPRESSIVE STRENGTH OF 30 MPa AT 28 DAYS. TYPE 50 CEMENT SHALL BE USED. AIR CONTENT 5% TO 7% MAXIMUM SLUMP 80 MM.
9. CHAMFER ALL EXTERIOR CONCRETE CORNERS 25 MM.
10. ALL MECHANICAL EQUIPMENT AND ANCHOR BOLTS SHALL BE INSTALLED IN ACCORDANCE WITH CERTIFIED SHOP DRAWINGS SUPPLIED BY THE EQUIPMENT SUPPLIER AND EXAMINED BY THE ENGINEER. ANCHOR BOLT PLACEMENT TOLERANCE SHALL BE +/- 3 MM.
11. ALL REINFORCING STEEL SHALL BE NEW BILLET STEEL, GRADE 400, DEFORMED BARS CONFORMING TO CSA G30.12.
12. ALL REINFORCING STEEL IN SLABS MUST BE SUPPORTED ON 1,200 MM CENTRES MINIMUM.
13. CONCRETE COVER FOR REINFORCING STEEL SHALL BE:  
A) UNFORMED CONCRETE AGAINST GROUND 75mm CLEAR  
B) FORMED CONCRETE EXPOSED TO WEATHER, WATER, OR GROUND 50mm CLEAR BEFORE PLACING CONCRETE.
14. EMBEDDED MATERIALS SHALL BE IN POSITION AND SECURELY FASTENED IN PLACE BEFORE PLACING CONCRETE.
15. ALL CONCRETE CONSTRUCTION TO BE IN ACCORDANCE WITH CSA CAN3-A23.
16. ALL FORMED CONCRETE SURFACES SHALL BE STANDARD SURFACE FINISH TYPE 6, UNLESS OTHERWISE NOTED.
17. ALL EXPOSED WALLS SHALL BE TYPE 5 SACK RUBBED FINISH.
18. SANDBLASTING THE JOINT TO EXPOSE THE COARSE AGGREGATE MAY BE USED AS AN ALTERNATE TO KEYWAYS.

ST. MARY RIVER IRRIGATION DISTRICT  
ALBERTA ENVIRONMENT

Heritage Fund **RECORD DRAWING**  
DATE: 14-02-91 SIGNED: PROJECT SUPERVISOR

**DO NOT SCALE THIS DRAWING**


REV	D	M	Y	ISSUE / REVISION DESCRIPTION	DRN	SUPV	DES	CHK	ENG
2	10	01	91	ISSUED FOR RECORD DRAWING					
1	06	09	88	ISSUED FOR CONSTRUCTION					
0	24	06	88	ISSUED FOR TENDER					

ENGINEER / P.E.T. PERMIT TO PRACTICE  
UMA ENGINEERING LTD.  
Signature:   
Date: 26/07/88  
PERMIT NUMBER: P 329  
The Association of Professional Engineers,  
Geologists and Geophysicists of Alberta

**UMA** UMA Engineering Ltd.  
Engineers & Planners

**ST. MARY RIVER IRRIGATION DISTRICT  
MAIN CANAL REHABILITATION  
RIDGE RESERVOIR TO CHIN RESERVOIR REACH  
km.64 TO km.65  
DROP 14 - STA. 64+050  
SECTIONS SHT. 4 OF 31**

PROJECT No. 1758-060-00	CONTRACT 88-03C	<b>R</b>	DRAWING No. W2443	ISS / REV 2
----------------------------	--------------------	----------	----------------------	----------------

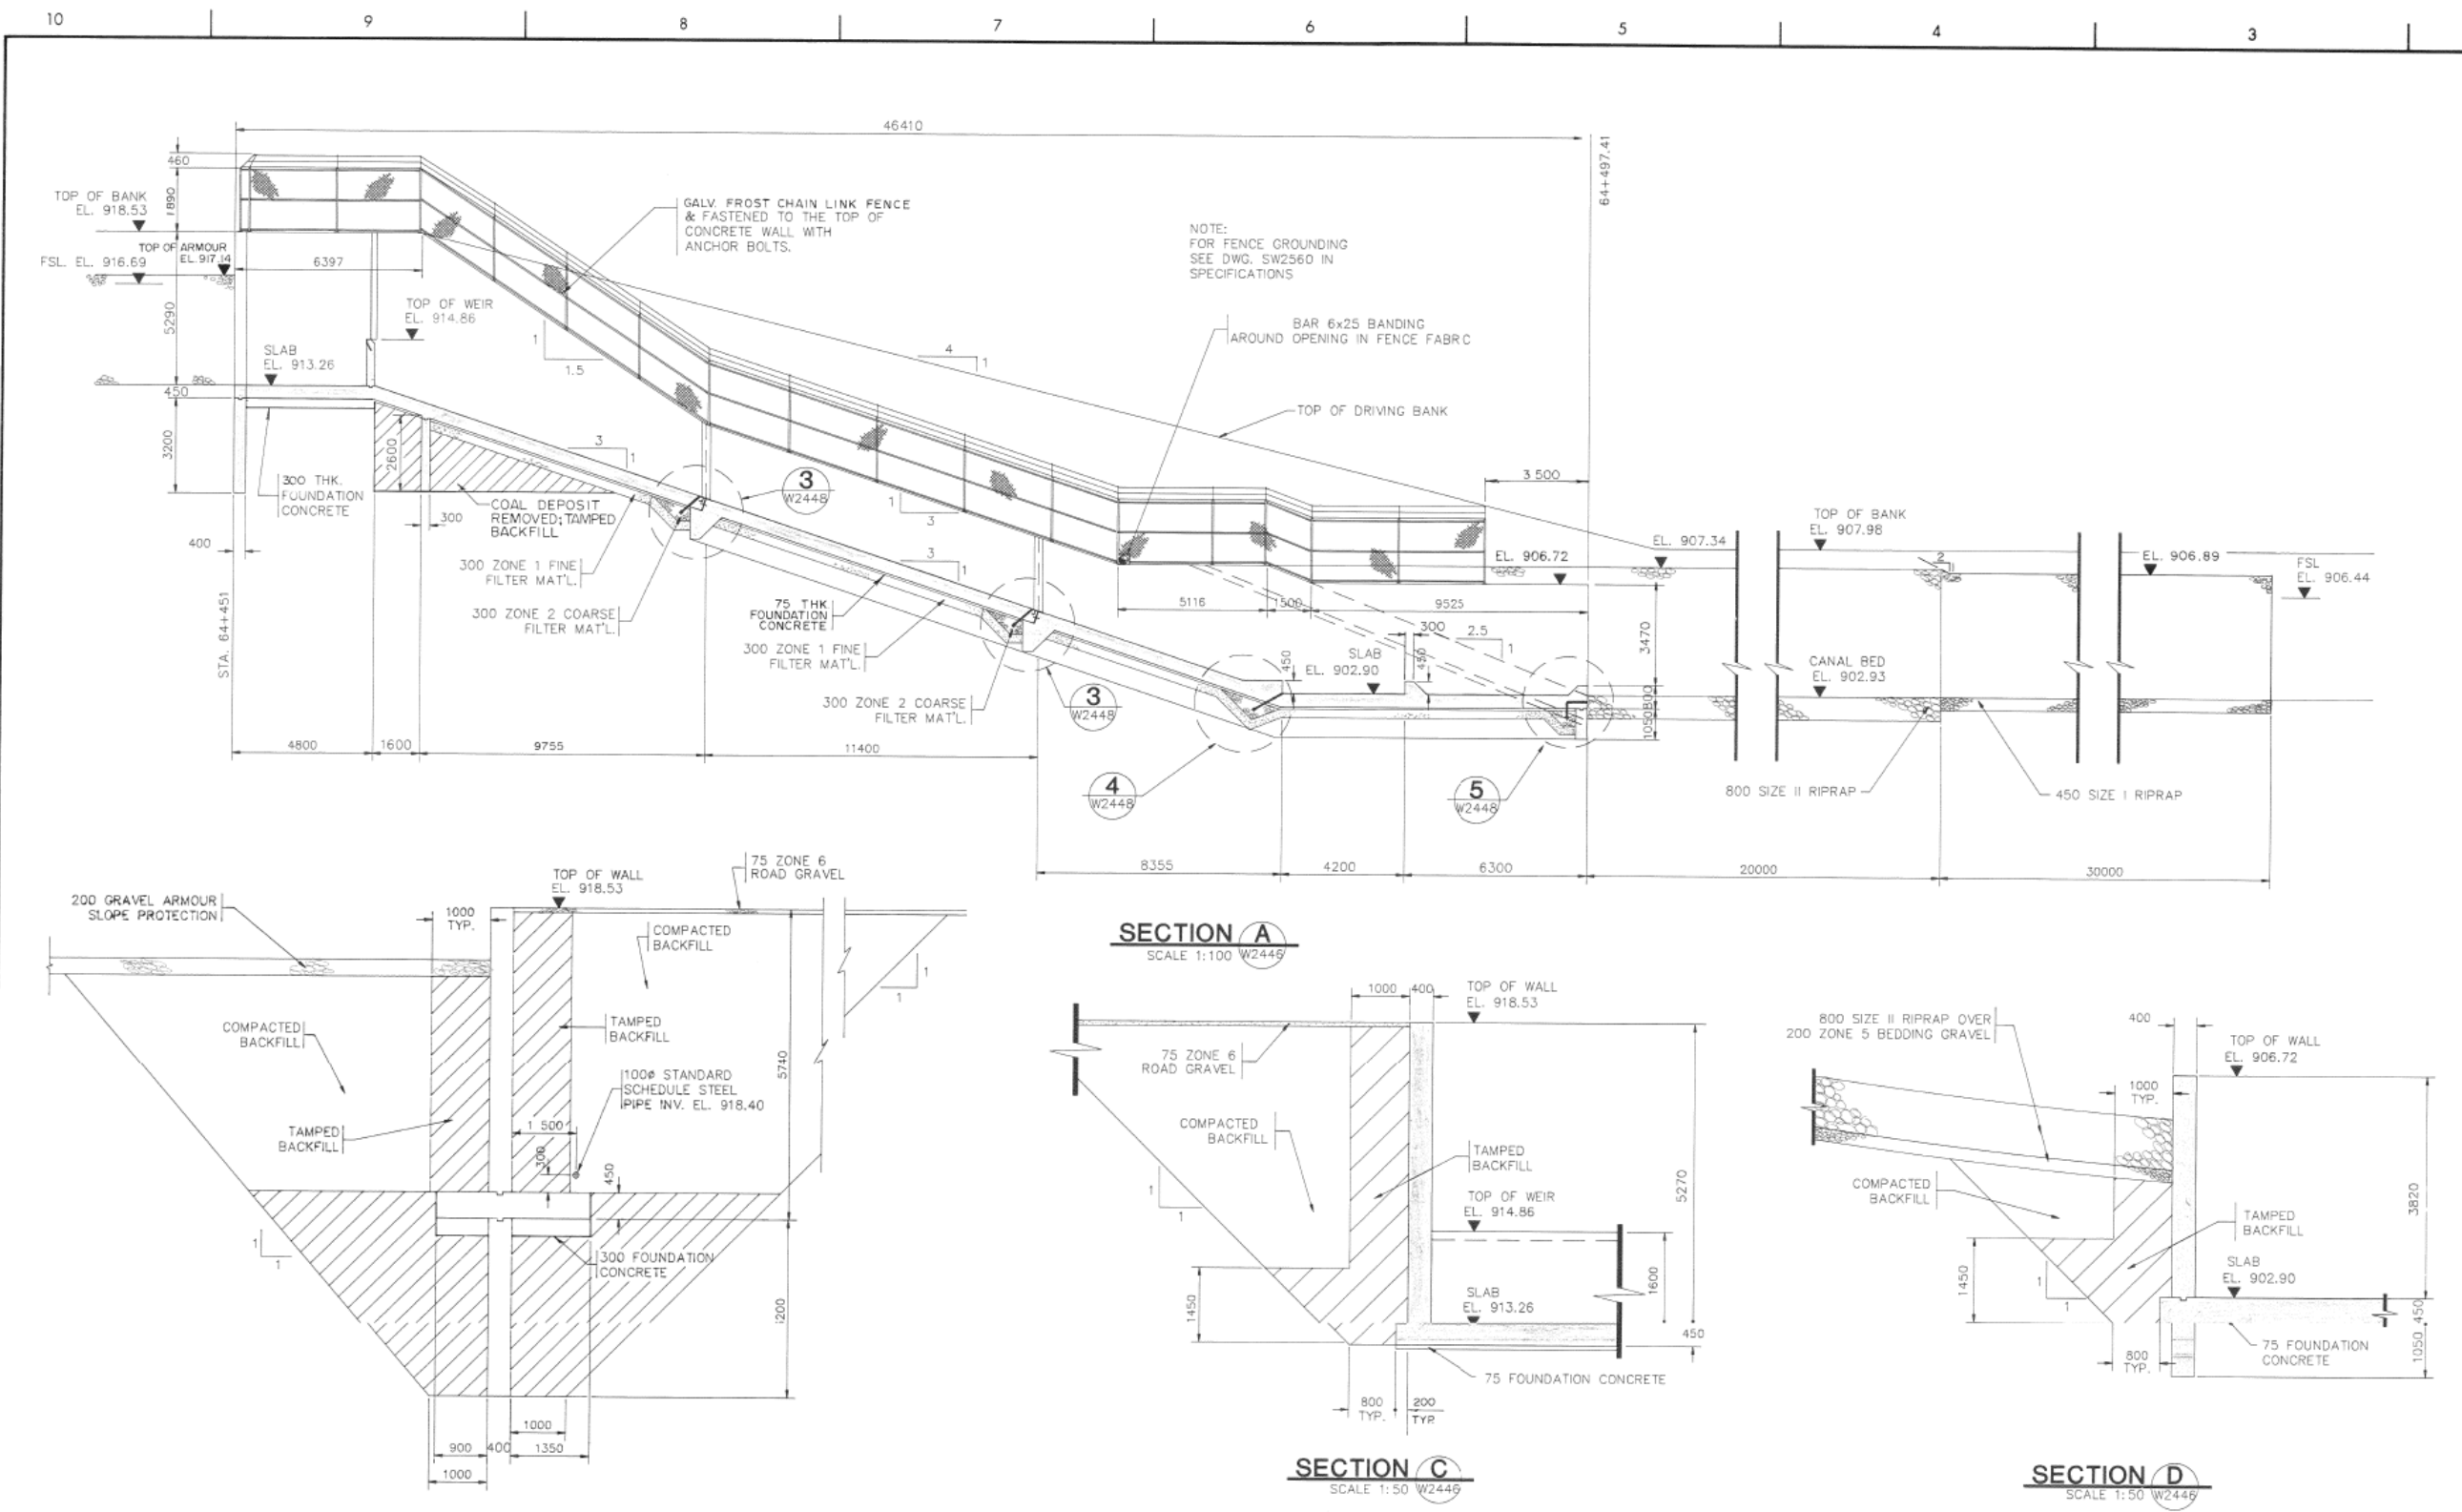

- GENERAL NOTES**
- ALL MISCELLANEOUS STEEL SHALL BE TO CSA G40.21 M. GRADE 300 W UNLESS OTHERWISE NOTED.
  - HOLLOW STRUCTURAL SECTIONS SHALL HAVE A MINIMUM YIELD STRENGTH OF 350 MPa.
  - ALL MISCELLANEOUS STEEL SHALL BE HOT DIPPED GALVANIZED UNLESS OTHERWISE NOTED.
  - HOT DIP GALVANIZING SHALL BE IN ACCORDANCE WITH CSA G164-M 1981.
  - CONTRACTOR SHALL PROVIDE ALL ANCHOR BOLTS IN STRICT ACCORDANCE WITH THE RELEVANT EQUIPMENT SUPPLIER'S CERTIFIED DRAWINGS.
  - ALL WELDING SHALL BE PERFORMED IN ACCORDANCE WITH CSA W59 - 1984, AND ALSO UNDER CSA W47.1 AND CSA W48 SERIES.
  - FABRICATION TOLERANCES AND BOLTED CONNECTIONS SHALL BE IN ACCORDANCE WITH CSA S16 SERIES.
  - ALL CONCRETE SHALL HAVE A MINIMUM COMPRESSIVE STRENGTH OF 30 MPa AT 28 DAYS. TYPE 50 CEMENT SHALL BE USED. AIR CONTENT 5% TO 7% MAXIMUM. SLUMP 80 MM.
  - CHAMFER ALL EXTERIOR CONCRETE CORNERS 25 MM.
  - ALL MECHANICAL EQUIPMENT AND ANCHOR BOLTS SHALL BE INSTALLED IN ACCORDANCE WITH CERTIFIED SHOP DRAWINGS SUPPLIED BY THE EQUIPMENT SUPPLIER AND EXAMINED BY THE ENGINEER. ANCHOR BOLT PLACEMENT TOLERANCE SHALL BE +/- 3 MM.
  - ALL REINFORCING STEEL SHALL BE NEW BILLET STEEL, GRADE 400, DEFORMED BARS CONFORMING TO CSA C30.12.
  - ALL REINFORCING STEEL IN SLABS MUST BE SUPPORTED ON 1,200 MM CENTRES MINIMUM.
  - CONCRETE COVER FOR REINFORCING STEEL SHALL BE:
    - A) UNFORMED CONCRETE AGAINST GROUND 75mm CLEAR
    - B) FORMED CONCRETE EXPOSED TO WEATHER, WATER, OR GROUND 50mm CLEAR
  - EMBEDDED MATERIALS SHALL BE IN POSITION AND SECURELY FASTENED IN PLACE BEFORE PLACING CONCRETE.
  - ALL CONCRETE CONSTRUCTION TO BE IN ACCORDANCE WITH CSA CAN3-A23.
  - ALL FORMED CONCRETE SURFACES SHALL BE STANDARD SURFACE FINISH TYPE 6, UNLESS OTHERWISE NOTED.
  - ALL EXPOSED WALLS SHALL BE TYPE 5 SACK RUBBED FINISH.
  - SANDBLASTING THE JOINT TO EXPOSE THE COARSE AGGREGATE MAY BE USED AS AN ALTERNATE TO KEYWAYS.

**ST. MARY RIVER IRRIGATION DISTRICT**  
ALBERTA ENVIRONMENT

**Heritage Fund**

**RECORD DRAWING**  
DATE 10-09-11 SIGNED [Signature] PROJECT SUPERVISOR

**DO NOT SCALE THIS DRAWING**

REV	D	M	Y	ISSUE / REVISION DESCRIPTION	DRN	SUPV	DES	CHK	ENG
2	18	01	91	ISSUED FOR RECORD DRAWING					
1	06	09	88	ISSUED FOR CONSTRUCTION					
0	22	08	86	ISSUED FOR TENDER					

ENGINEER / R.E.T. [Signature]

PERMIT TO PRACTICE  
UMA ENGINEERING LTD.  
Signature [Signature]  
Date 10/02/11  
PERMIT NUMBER: P 329  
The Association of Professional Engineers, Geologists and Geophysicists of Alberta

**UMA** UMA Engineering Ltd.  
Engineers & Planners

**ST. MARY RIVER IRRIGATION DISTRICT**  
MAIN CANAL REHABILITATION  
RIDGE RESERVOIR TO CHIN RESERVOIR REACH  
km.64 TO km.65  
DROP 15 - STA. 64+451

SECTIONS SHT. 8 OF 31

PROJECT No. 1758-060-00	CODE CONTRACT 88-03C	DRAWING No. <b>R W2447</b>	ISS/REV <b>2</b>
----------------------------	----------------------------	-------------------------------	---------------------

3.6 Potential Hydroelectric Project Investigations within the St. Mary River Project  
(UMA, 2001)

**[Hard copy available upon request]**

3.7 Relevant Historical Data [**CD available upon request**]

Daily Flows, 1994-2009

Daily reservoir elevation data, 1994-2009

Scan of main canal cross sections and drop structures